



Department of Public Works  
Infrastructure Services Division

Ghassan Korban  
Commissioner of Public Works

Preston Cole  
Director of Operations

Jeffrey S. Polenske  
City Engineer

October 22, 2015

OFFICIAL NOTICE NO. 139-2015  
PROJECT NUMBER 1

ADDENDUM NO. 1

NOTICE TO CONTRACTORS intending to bid on Official Notice No. 139-2015, Project 1, which appeared in the *Daily Reporter* with a bid opening date of Monday, October 26, 2015 at 10:30 AM.

1. Special Provision No. 33 on Plan File No. 242-12 shall be changed to read the following:


33. THE 15-INCH DIAMETER SANITARY SEWER BETWEEN MANHOLE NUMBER 243C532 TO 244C532 ARE ENCASED IN CONCRETE. (SEE PLAN FILE NUMBERS 239-5, 239-6, 239-8, 239-9, AND 239-12.) THE MANHOLES ASSOCIATED WITH THESE SEWERS ARE NON-STANDARD MANHOLES WHICH SERVE AS DUAL SANITARY AND COMBINED MANHOLES AND HAVE DOUBLE BARRELED CHAMBERS BELOW THE CORBELS. THE INTENT IS TO COMPLETELY LINE THE ENTIRE MANHOLE SURFACE AREA.

THE TYPICAL AS-BUILT PLANS FOR THESE SEWERS AND MANHOLES ARE LOCATED IN THE BID PACKAGE AND PROVIDED IN AN 11-INCH BY 17-INCH (11" X 17") FORMAT. BIDDERS MAY CONTACT ZAFAR YOUSUF OF THE ENVIRONMENTAL ENGINEERING SECTION (EES) AT (414) 286-2467 TO REQUEST FULL SIZE PLANS. FULL SIZE PLANS WILL BE MADE AVAILABLE WITHIN TWO (2) DAYS OF THE REQUEST AT NO EXTRA COST TO THE CONTRACTOR. UPON AWARD OF THE CONTRACT, THE WINNING CONTRACTOR SHALL RECEIVE A LIMITED NUMBER OF FULL SIZE PLANS.

2. Typical as-built plan for the manholes described above in the revised Special Provision No. 33 is attached.

NOTE: The contractor shall acknowledge receipt of Addendum Number 1 on page 6 of the Bid Document titled "ACKNOWLEDGEMENTS PAGE."

Very truly yours,

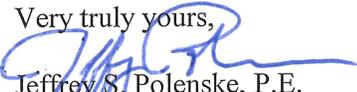  
Jeffrey S. Polenske, P.E.  
City Engineer

Attachments

ZY: WR

15-2


c: William Frasch



SHAFT DETAILS AT N. HUBBARD ST.

Note:— Stub connections shall be provided with suitable bulkheads.

M.H. DETAIL AT N. HUMBOLDT AVE.

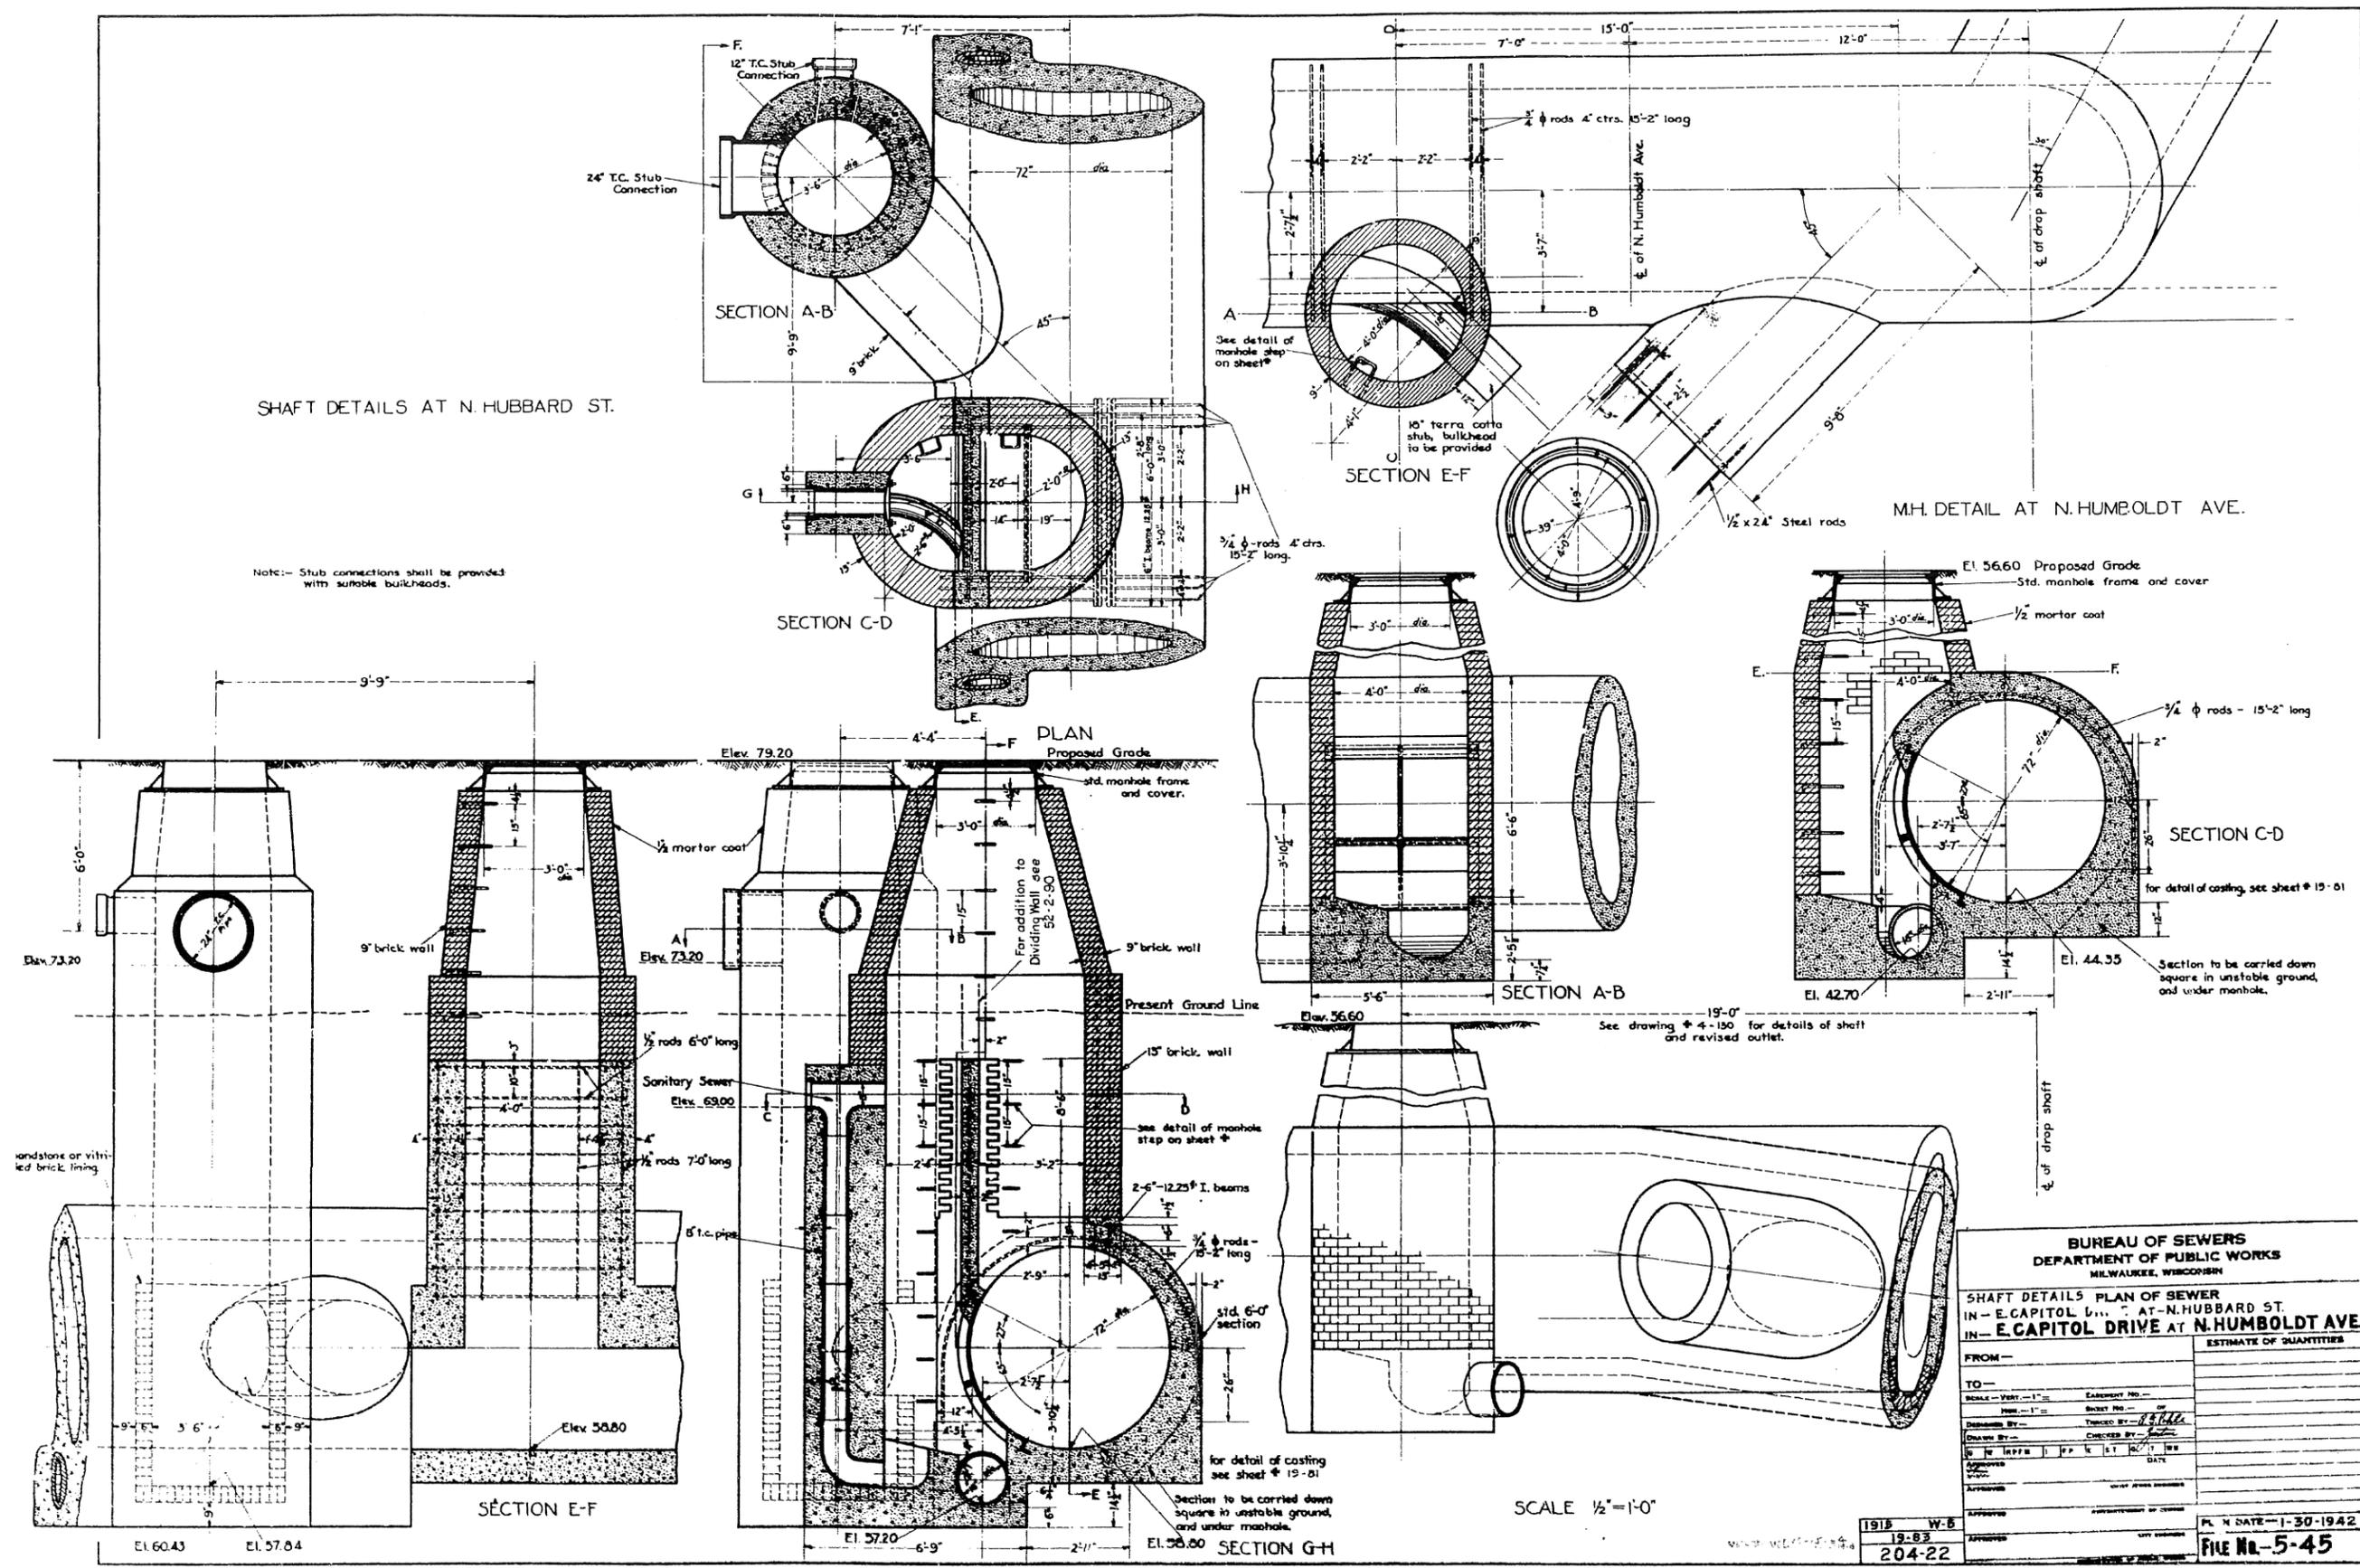

BUREAU OF SEWERS DEPARTMENT OF PUBLIC WORKS MILWAUKEE, WISCONSIN	
SHAFT DETAILS PLAN OF SEWER IN - E. CAPITOL DRIVE AT N. HUBBARD ST. IN - E. CAPITOL DRIVE AT N. HUMBOLDT AVE.	
ESTIMATE OF QUANTITIES	
FROM -	
TO -	
SCALE - VERT. - 1" = 10'	DATE - 1-30-1942
DESIGNED BY -	CHECKER BY -
DRAWN BY -	DATE -
APPROVED -	
1918 W-6	204-22
19-83	
FILE NO. - 5-45	

SCALE 1/2" = 1'-0"

Elev. 60.43 Elev. 57.84

Elev. 57.20 Elev. 58.80 SECTION G-H